

APPENDIX B

As-built Plans for Containment Sites



NOTES:

[illegible]

Pld Date: 02Nov-18 1:17 PM
File path: D:\V-Civil Jobs Directory\2018\18-007 - Kopeopeo Canal Remedial Containment Site 32 - CAD\01 Current DWG FILE



NOTES:

- ALL AS-BUILT INFORMATION PROVIDED BY WAIOTAHİ CONTRACTORS AND ENVIRONZ
- INFORMATION ON THIS PLAN WAS OBTAINED FROM HAND-MARKUPS AND TRACED.

			DRAWN BY: JDT		SIGNED:	DATE: 02.11.18	<div>WEC</div> <div>water engineering consultants</div>	<div>EnviroNZ</div> <div><small>COPYRIGHT - This drawing, the design and concept, remains the exclusive property of WEC and may not be used without approval. Copyright reserved.</small></div>	TITLE: KOPEOPEO CANAL REMEDIAL CONTAINMENT SITE 1 EARTHWORKS AS-BUILT PLANS - ROTTEN ROCK SURFACE LEVELS	ORIGINAL SCALE A3	Project No.
			DESIGNED BY: CJS		SIGNED:	DATE: 02.11.18				1:1250	48001
			CHECKED BY: CJS		SIGNED:	DATE: 02.11.18				DRAWING No.	REVISION
			APPROVED FOR RELEASE BY: CJS		SIGNED:	DATE: 02.11.18				14	A
REVISION	DATE	AMENDMENT	BY	APPD.							

Pld Date: 02Nov-18 1:17 PM
File path: D:\Ar Civil Jobs Directory\2018\18-007 - Kopeopeo Canal Remedial Containment Site 32 - CAD\01 Current DWG FILE




NOTES:

- ALL AS-BUILT INFORMATION PROVIDED BY WAIOTAHİ CONTRACTORS AND ENVIRONZ
- INFORMATION ON THIS PLAN WAS OBTAINED FROM HAND-MARKUPS AND TRACED.

			DRAWN BY:		SIGNED:	DATE:	<div>WEC</div> <div>water engineering consultants</div>		<div>EnviroNZ</div> <div>COPYRIGHT - This drawing, the design and concept, remains the exclusive property of WEC and may not be used without approval. Copyright reserved.</div>		TITLE:		ORIGINAL SCALE A3	Project No.
			DESIGNED BY:		SIGNED:	DATE:							1:1250	48001
			CHECKED BY:		SIGNED:	DATE:							DRAWING No.	REVISION
			APPROVED FOR RELEASE BY:		SIGNED:	DATE:							15	A
A	02.11.18	INITIAL ISSUE	JDT	CJS							KOPEOPEO CANAL REMEDIAL CONTAINMENT SITE 1 EARTHWORKS AS-BUILT PLANS - CLAY SURFACE LEVELS			
REVISION	DATE	AMENDMENT	BY	APPD.	CJS									


- NOTES:
- ALL AS-BUILT INFORMATION PROVIDED BY WAIOTAHİ CONTRACTORS AND ENVIRONZ
 - INFORMATION ON THIS PLAN WAS OBTAINED FROM HAND-MARKUPS AND TRACED.

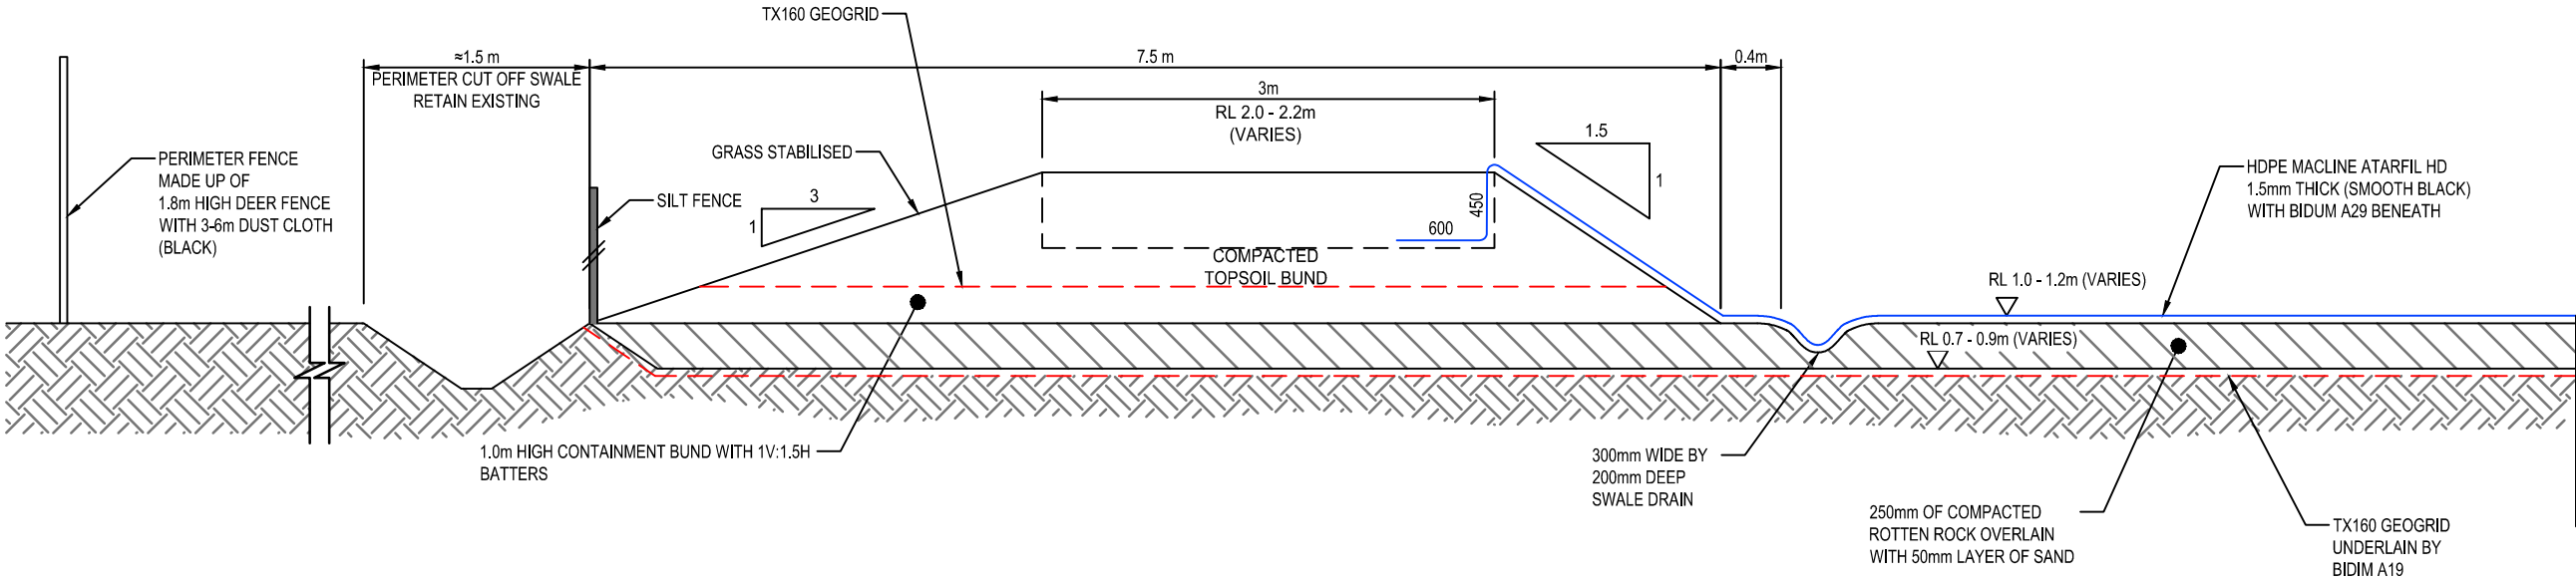

SECTION A
13

Plot Date: 02Nov-18 1:17 PM
File path: D:\Ar Civil Jobs Directory\2018\PIB-007 - Koepopeo Canal Remedial Containment Site 302 - CAD\01 Current DWG FILE

						DRAWN BY:	SIGNED:	DATE:			TITLE: KOPEOPEO CANAL REMEDIAL CONTAINMENT SITE 1 EARTHWORKS AS-BUILT CROSS SECTION	ORIGINAL SCALE A3	Project No.		
					JDT		02.11.18	1:50				48001			
					DESIGNED BY:	SIGNED:	DATE:	DRAWING No.				REVISION			
					CJS		02.11.18								
					CHECKED BY:	SIGNED:	DATE:								
					CJS		02.11.18								
A	02.11.18	INITIAL ISSUE			JDT	CJS	APPROVED FOR RELEASE BY:	SIGNED:	DATE:						
REVISION	DATE	AMENDMENT			BY	APPD.	CJS	02.11.18	COPYRIGHT - This drawing, the design and concept, remain the exclusive property of WEC and may not be used without approval. Copyright reserved.						

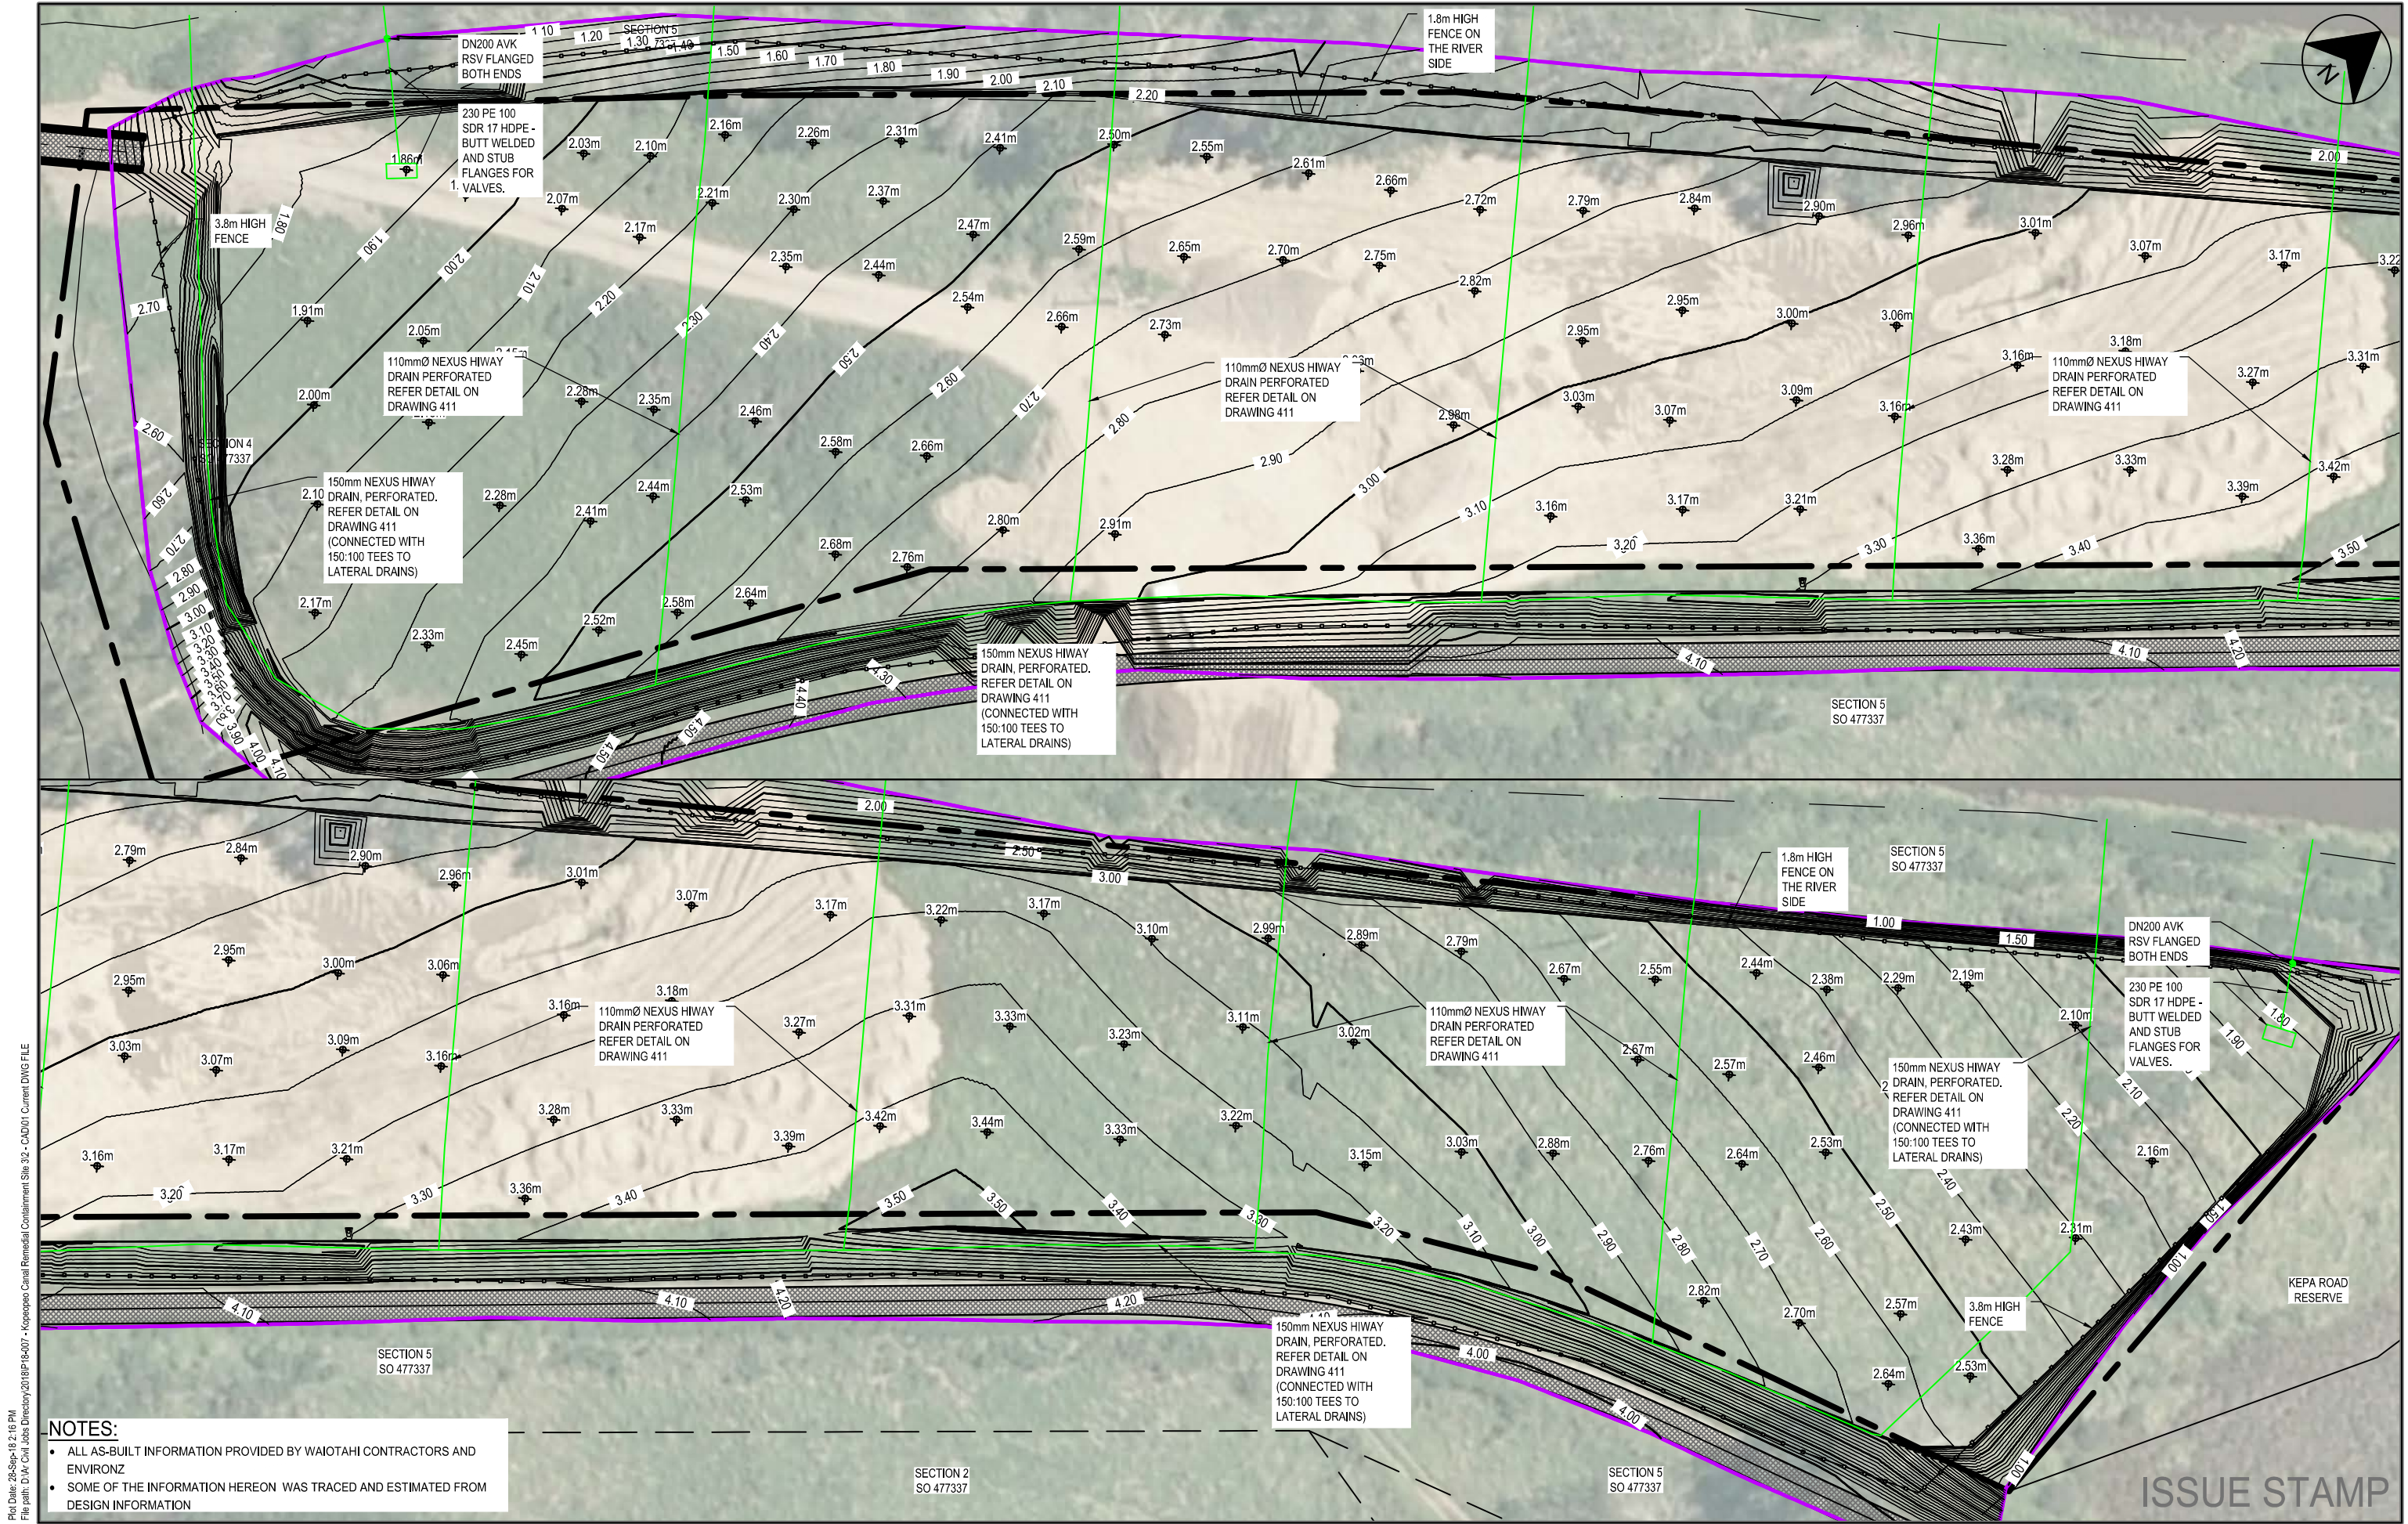


NOTES:

- ALL AS-BUILT INFORMATION PROVIDED BY WAIOTAH CONTRACTORS AND ENVIRONZ
- SOME OF THE INFORMATION HEREON WAS TRACED AND ESTIMATED FROM DESIGN INFORMATION

Pld Date: 28-Sep-18 2:16 PM
File path: D:\Civil\Jas\Directory\2018\18-07 - Koepoe Canal Remedial Containment Site 3 - CAD\01 Current DWG FILE

			DRAWN BY: JDT		SIGNED:	DATE: 20.19.18	<div>WEC</div> <div>water engineering consultants</div>	<div>EnviroNZ</div> <div><small>COPYRIGHT - This drawing, the design and concept, remains the exclusive property of WEC and may not be used without approval. Copyright reserved.</small></div>	TITLE: KOPEOPEO CANAL REMEDIAL CONTAINMENT SITE 3 AS-BUILT BUND BOTTOM SURFACE LEVELS	ORIGINAL SCALE A3	Project No.
			DESIGNED BY: CJS		SIGNED:	DATE: 20.19.18				1:600	48001
			CHECKED BY: CJS		SIGNED:	DATE: 20.19.18				DRAWING No.	REVISION
			APPROVED FOR RELEASE BY:		SIGNED:	DATE: 20.19.18				402	A
A	20.19.18	INITIAL ISSUE	JDT	CJS							
REVISION	DATE	AMENDMENT	BY	APPD.	CJS						


Plot Date: 28-Sep-18 2:16 PM
File path: D:\Ar Civil Jobs Directory\2018\18-07 - Kopeopeo Canal Remedial Containment Site 32 - CAD\01 Current DWG FILE

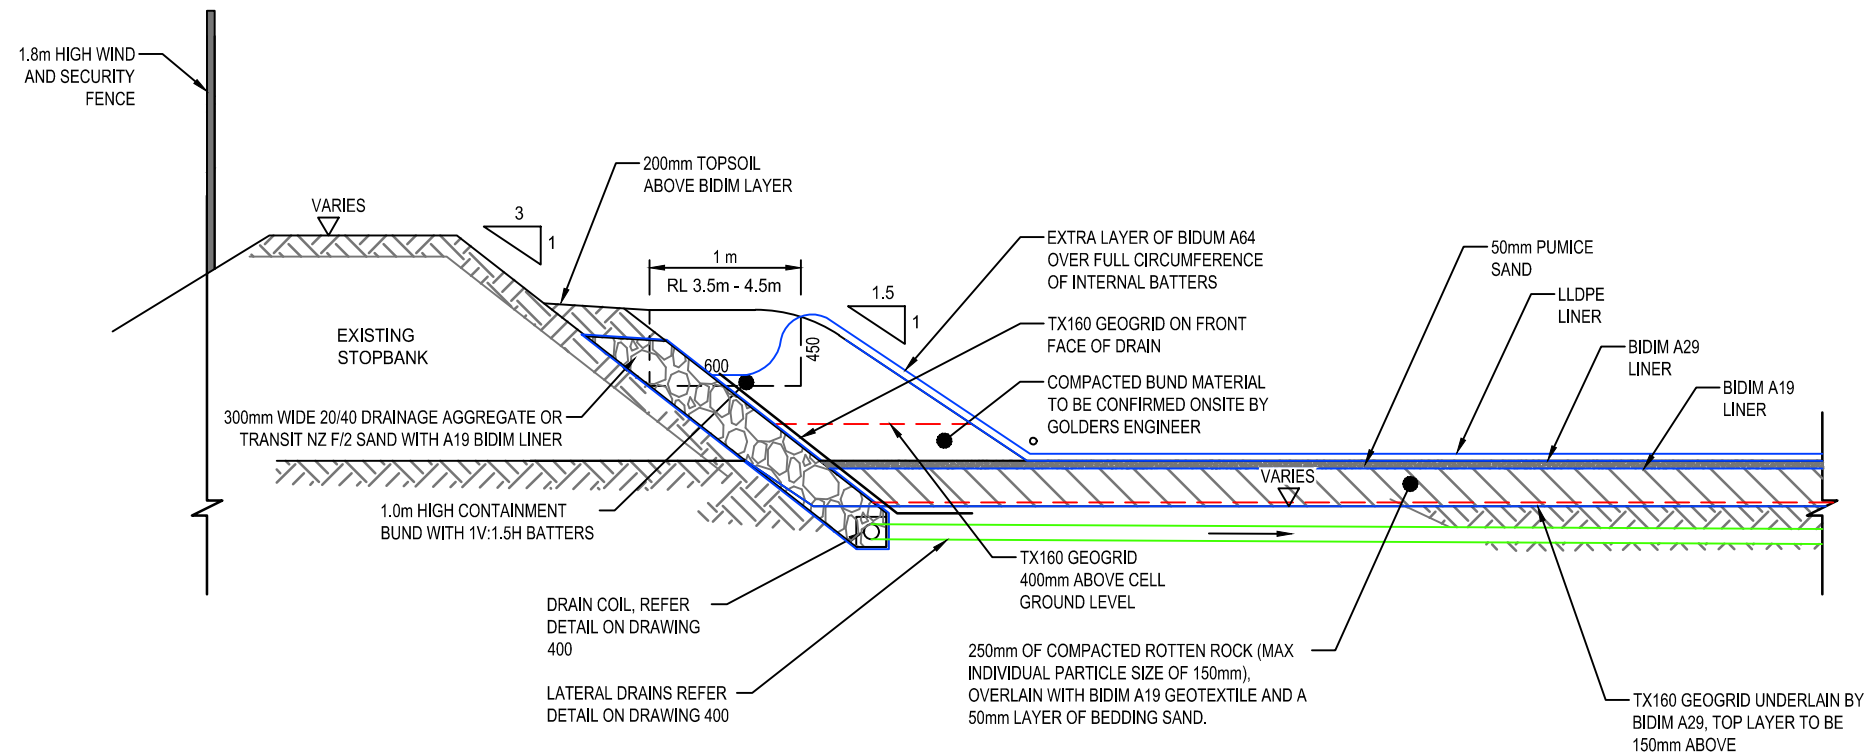

SECTION C
403

NOTES:

- ALL AS-BUILT INFORMATION PROVIDED BY WAIOTAHU CONTRACTORS AND ENVIRONZ
- ALL DETAILS ON CROSS SECTIONS ARE COPIED AND ASSUMED FROM DESIGN DRAWINGS

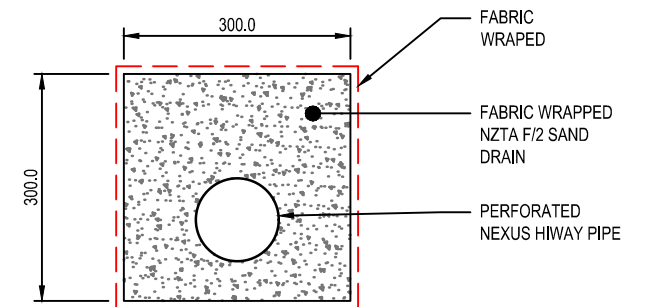

TYPICAL CS3 LATERAL DRAINS
DETAILS

NOTES:
110mm OD
100mm ID

ISSUE STAMP

					DRAWN BY: JDT	SIGNED:	DATE: 20.19.18	 	TITLE: KOPEOPEO CANAL REMEDIAL CONTAINMENT SITE 3 AS-BUILT CROSS SECTIONS - SHEET 2	ORIGINAL SCALE A3	Project No. 48001
					DESIGNED BY: CJS	SIGNED:	DATE: 20.19.18			1:50	
					CHECKED BY: CJS	SIGNED:	DATE: 20.19.18			DRAWING No.	REVISION
A	20.19.18	INITIAL ISSUE		JDT	CJS	APPROVED FOR RELEASE BY:	DATE: 20.19.18			411	A
REVISION	DATE	AMENDMENT	BY	APPD.	CJS						